



SHOP DRAWINGS — ELECTRICAL / AGL SCOPE

RECTIFICATION OF TWY E BETWEEN E4 & E6 (ZIA)

AGL WORKS AT THREE (3) MILLING LOCATIONS — FIELD CONDITION SCOPE

REV P07 — SCOPE PER FIELD SHEETS Document_3 (LOC-01) AND Second_milling_area rev _1 (LOC-02 / LOC-03)

Document No.

AUH-SK-AGL-TWYE-001

Base layer

As-built AGL asset survey assets_20260726120533.xlsx — UTM 40N (EPSG:32640)

Prepared by

Mohammed — AGL Team Leader, ADB SAFEGATE AGL Team · Issued 28.07.2026 · Rev P07 30.07.2026

Approved by

Ragesh Menon — AGL Manager, ADB SAFEGATE AGL Team



LOCATION 1 — 1001 · REV P07 (ISSUED)

SCOPE PER FIELD SHEET Document_3 (15 No. LIGHTS LISTED) — FIELD CONDITION GOVERNS

Sheet A3 (420 x 297 mm) · NOT TO SCALE — approx. 1:465 as plotted · UTM 40N · Issued 28.07.2026 · Rev P07 30.07.2026 · Prepared: Mohammed, AGL Team Leader — ADB SAFEGATE · Approved: Ragesh Menon, AGL Manager

SCOPE / QUANTITIES (PER FIELD VERIFICATION)

CORE OUT SHALLOW BASE + NEW CABLE: 11 No. (SEC. CABLE YES / SHALLOW BASE YES)

- VIA DUCT (6): SBC102-02/024, 01/027, 02/025, 01/028, 02/026, 01/029
- VIA SAWCUT (5): TCCECH-04/034, 03/036, 04/035, 03/037, 04/036

NEW SECONDARY CABLE ONLY — NO CORING: 3 No. (SEC. CABLE YES / SHALLOW BASE NO)

- VIA DUCT (1): SBC102-02/027
- VIA SAWCUT (2): TCCECH-03/035, 03/018 — 0.49 m apart, one shared label; bases sound, verify at cut line

FIELD VERIFIED NOT AFFECTED: SBC102-01/026 (SEC. CABLE NO / SHALLOW BASE NO — no works)

FIELD SHEET TOTAL: 15 No. — 14 secondary cables, 11 core-outs, 0 dummy plates

NOT ON FIELD SHEET — CONFIRM BEFORE WORKS: TCC103-11/021, 11/126, 12/021, 12/022

- secondary routes appear to cross the cut; not listed on Document_3 — shown grey, no action assumed

ISOLATE CIRCUITS: SBC102.01/.02, TCCECH.03/.04

SITE RECORD 23.07.2026: 9 cored + 2 reinstatement completed

GENERAL NOTES

1. All asset positions as-built (asset survey assets_20260726120533.xlsx, UTM 40N / EPSG:32640).
2. AGL works demarcation (red) drawn around field-verified affected assets (+2.0 m) — field condition governs.
3. Secondary cables: no joints — full manhole-to-light replacement. Confirm routes vs AGL duct-layout CAD (Rev C) before works.
4. Isolate, lock out & prove dead all listed circuits at CCR under permit before any cutting, coring or excavation.
5. Reinstatement setting-out by civil survey from as-built E/N, checked against adjacent undisturbed fittings before coring.
6. Rev P07: every asset on this sheet re-marked directly from field sheet Document_3 — outer ring from the Secondary-cable / Shallow-base columns, inner disc from Duct / Sawcut. Assets not listed on the field sheet are shown grey with no action assumed.
7. Existing assets carry the symbol of their as-built class — see legend. Class is resolved from the AGL asset survey against the AGL duct-layout CAD; where an asset is labelled the label governs. Where a works marker is drawn the asset symbol sits beneath it, so legend counts include assets under works markers. Civil items (handhole / manhole / pits / RRM) plot about 2.1 m from the surveyed insertion point — set out from survey, not from this sheet, and confirm the individual pit before works.

WORKS ACTIONS


- CORE OUT + NEW CABLE (DUCT)
- CORE OUT + NEW CABLE (SAWCUT)
- NEW SEC. CABLE ONLY (DUCT)
- NEW SEC. CABLE ONLY (SAWCUT)
- NOT AFFECTED / NOT ON FIELD SHEET

AREAS & LINEWORK

- MILLING / CUT AREA
- AGL WORKS DEMARCATION (GOVERNING)
- SECONDARY DUCT CROSSING CUT (INDIC.)
- INDICATIVE DUCT — LIGHT TO MH / HH
- TAXIWAY CENTRELINE (THROUGH TCC)
- STOP BAR (THROUGH SBC)
- TWY EDGE / PAVEMENT (INDIC. 23 m)

EXISTING ASSETS (AS-BUILT)

- Taxiway centreline light ×21
- Stop bar light ×2
- Taxiway edge light ×4
- Runway guard light / RRM ×4
- Sign foundation ×2
- Handhole ×11
- Manhole ×2
- Existing manhole ×1
- Existing transformer handhole ×5
- Earthing pit ×1
- Earthing point ×1
- AGL feed manhole / handhole

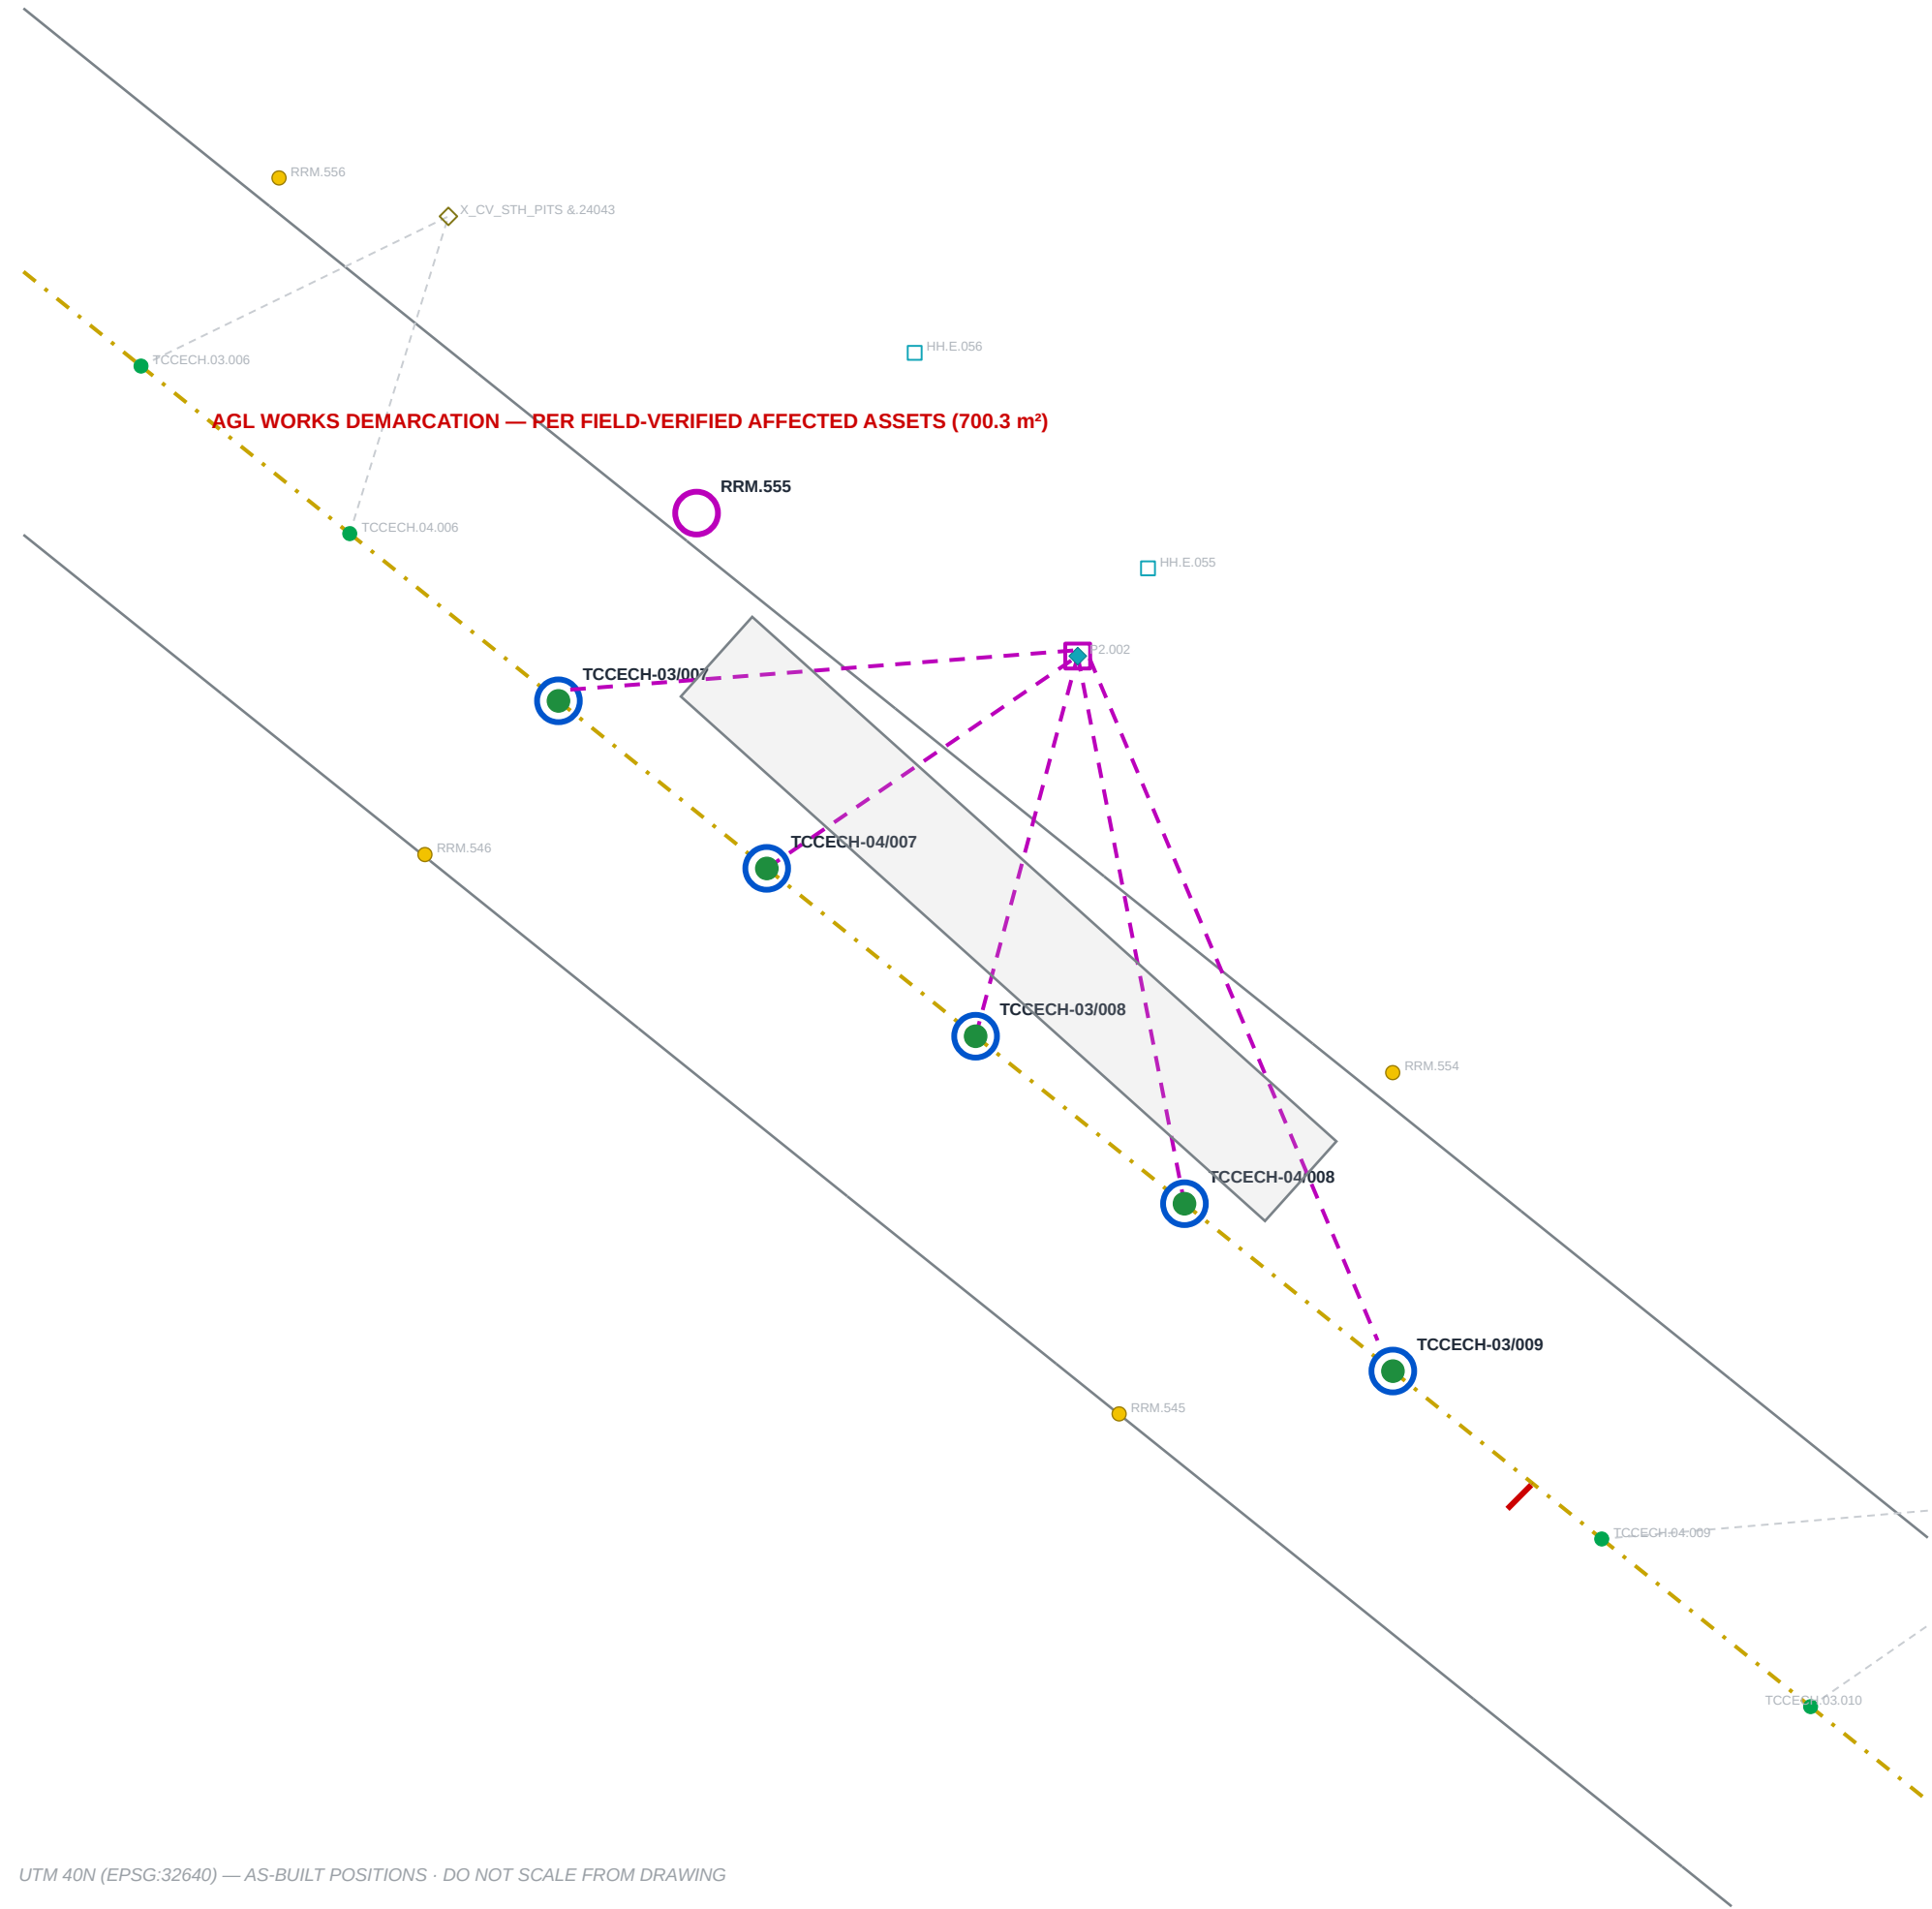

LOCATION 2 — 1002 · REV P07 (ISSUED)

SCOPE PER FIELD SHEET Second_milling_area rev _1 (5 No. LIGHTS LISTED) — FIELD CONDITION GOVERNS

Sheet A3 (420 x 297 mm) · NOT TO SCALE — approx. 1:465 as plotted · UTM 40N · Issued 28.07.2026 · Rev P07 30.07.2026 · Prepared: Mohammed, AGL Team Leader — ADB SAFEGATE · Approved: Ragesh Menon, AGL Manager

SCOPE / QUANTITIES (PER FIELD VERIFICATION)

NEW SECONDARY CABLE ONLY (VIA DUCT): 5 No.
• TCCECH-03/007, 04/007, 03/008, 04/008, 03/009
NO SHALLOW BASES AFFECTED — COLUMN BLANK ON FIELD SHEET, CONFIRMED 'NO' 30.07.2026; NO ASSET LIES INSIDE THE MILLING POLYGON
RRM.555 (0.41 m from cut): REMOVE / PROTECT BEFORE SAWCUT, RE-FIX AFTER PAVING
ISOLATE CIRCUITS: TCCECH.03, TCCECH.04

GENERAL NOTES

- All asset positions as-built (asset survey assets_20260726120533.xlsx, UTM 40N / EPSG:32640).
- AGL works demarcation (red) drawn around field-verified affected assets (+2.0 m) — field condition governs.
- Secondary cables: no joints — full manhole-to-light replacement. Confirm routes vs AGL duct-layout CAD (Rev C) before works.
- Isolate, lock out & prove dead all listed circuits at CCR under permit before any cutting, coring or excavation.
- Reinstatement setting-out by civil survey from as-built E/N, checked against adjacent undisturbed fittings before coring.
- Rev P07: every asset on this sheet re-marked directly from field sheet Second_milling_area rev _1 (2nd table) — outer ring from the Secondary-cable / Shallow-base columns, inner disc from Duct / Sawcut. Assets not listed on the field sheet are shown grey with no action assumed. Shallow-base column blank on that sheet; confirmed 'NO' 30.07.2026.
- Existing assets carry the symbol of their as-built class — see legend. Class is resolved from the AGL asset survey against the AGL duct-layout CAD; where an asset is labelled the label governs. Where a works marker is drawn the asset symbol sits beneath it, so legend counts include assets under works markers. Civil items (handhole / manhole / pits / RRM) plot about 2.1 m from the surveyed insertion point — set out from survey, not from this sheet, and confirm the individual pit before works.

WORKS ACTIONS

NEW SEC. CABLE ONLY (DUCT)

RRM — REMOVE / PROTECT / RE-FIX

AREAS & LINEWORK

MILLING / CUT AREA

AGL WORKS DEMARCATION (GOVERNING)

SECONDARY DUCT CROSSING CUT (INDIC.)

INDICATIVE DUCT — LIGHT TO MH / HH

TAXIWAY CENTRELINE (THROUGH TCC)

TWY EDGE / PAVEMENT (INDIC. 23 m)

EXISTING ASSETS (AS-BUILT)

Taxiway centreline light ×9

Runway guard light / RRM ×4

Handhole ×2

Existing transformer handhole ×1

Earthing pit ×1

AGL feed manhole / handhole



LOCATION 3 — 1003 · REV P07 (ISSUED)

SCOPE PER FIELD SHEET Second_milling_area rev _1 (12 No. LIGHTS LISTED) — FIELD CONDITION GOVERNS (supersedes the earlier no-works revision)

Sheet A3 (420 x 297 mm) · NOT TO SCALE — approx. 1:465 as plotted · UTM 40N · Issued 28.07.2026 · Rev P07 30.07.2026 · Prepared: Mohammed, AGL Team Leader — ADB SAFEGATE · Approved: Ragesh Menon, AGL Manager

SCOPE / QUANTITIES (PER FIELD VERIFICATION)

SHALLOW BASE AFFECTED — NO CORING; DUMMY PLATE + CABLE (SAWCUT): 4 No.
• SBC102-01/038, 01/039, 02/035, 02/036 (EP7 STOP BAR)
NEW SECONDARY CABLE ONLY (VIA DUCT): 8 No.
• SBC102-01/040, 01/041, 02/037, 02/038, TCCECH-03/002, 04/002, 03/003, 04/003
FIELD SHEET TOTAL: 12 No. — all 12 secondary-cable affected; 4 shallow-base affected (YES)
RRM.557 (0.07 m — treat as within works) & RRM.670: REMOVE / PROTECT / RE-FIX
ISOLATE CIRCUITS: SBC102.01/02, TCCECH.03/04
DUMMY PLATES: 4 No. — NO CORING HERE; BASES RETAINED & BLANKED (BLACK SQUARE)

GENERAL NOTES

- All asset positions as-built (asset survey assets_20260726120533.xlsx, UTM 40N / EPSG:32640).
- AGL works demarcation (red) drawn around field-verified affected assets (+2.0 m) — field condition governs.
- Secondary cables: no joints — full manhole-to-light replacement. Confirm routes vs AGL duct-layout CAD (Rev C) before works.
- Isolate, lock out & prove dead all listed circuits at CCR under permit before any cutting, coring or excavation.
- Reinstatement setting-out by civil survey from as-built E/N, checked against adjacent undisturbed fittings before coring.
- Rev P07: every asset on this sheet re-marked directly from field sheet Second_milling_area rev _1 (1st table) — outer ring from the Secondary-cable / Shallow-base columns, inner disc from Duct / Sawcut. Assets not listed on the field sheet are shown grey with no action assumed.
- Existing assets carry the symbol of their as-built class — see legend. Class is resolved from the AGL asset survey against the AGL duct-layout CAD; where an asset is labelled the label governs. Where a works marker is drawn the asset symbol sits beneath it, so legend counts include assets under works markers. Civil items (handhole / manhole / pits / RRM) plot about 2.1 m from the surveyed insertion point — set out from survey, not from this sheet, and confirm the individual pit before works.

WORKS ACTIONS

- BASE RETAINED + DUMMY PLATE (SAWCUT)
- NEW SEC. CABLE ONLY (DUCT)
- RRM — REMOVE / PROTECT / RE-FIX
- FITTING LIFTED + OPENING PROTECTED

AREAS & LINEWORK

- MILLING / CUT AREA
- AGL WORKS DEMARCATION (GOVERNING)
- SECONDARY DUCT CROSSING CUT (INDIC.)
- INDICATIVE DUCT — LIGHT TO MH / HH
- TAXIWAY CENTRELINE (THROUGH TCC)
- STOP BAR (THROUGH SBC)
- TWY EDGE / PAVEMENT (INDIC. 23 m)

EXISTING ASSETS (AS-BUILT)

- Taxiway centreline light ×23
- Stop bar light ×4
- Runway guard light / RRM ×7
- Existing light base ×4
- Sign foundation ×2
- Handhole ×7
- Manhole ×2
- Existing manhole ×2
- Existing transformer handhole ×2
- AGL feed manhole / handhole

CONSOLIDATED FIELD-GOVERNED SCOPE — TWY E (E4–E6)



Loc	Asset	Works Action	Route	Remarks
LOC-01	SBC102-02/024	CORE OUT + NEW CABLE	Duct	Core out shallow base + full cable replacement
LOC-01	SBC102-01/027	CORE OUT + NEW CABLE	Duct	Core out shallow base + full cable replacement
LOC-01	SBC102-02/025	CORE OUT + NEW CABLE	Duct	Core out shallow base + full cable replacement
LOC-01	SBC102-01/028	CORE OUT + NEW CABLE	Duct	Core out shallow base + full cable replacement
LOC-01	SBC102-02/026	CORE OUT + NEW CABLE	Duct	Core out shallow base + full cable replacement
LOC-01	SBC102-01/029	CORE OUT + NEW CABLE	Duct	Core out shallow base + full cable replacement
LOC-01	TCCECH-04/034	CORE OUT + NEW CABLE	Sawcut	Core out shallow base + full cable replacement
LOC-01	TCCECH-03/036	CORE OUT + NEW CABLE	Sawcut	Core out shallow base + full cable replacement
LOC-01	TCCECH-04/035	CORE OUT + NEW CABLE	Sawcut	Core out shallow base + full cable replacement
LOC-01	TCCECH-03/037	CORE OUT + NEW CABLE	Sawcut	Core out shallow base + full cable replacement
LOC-01	TCCECH-04/036	CORE OUT + NEW CABLE	Sawcut	Core out shallow base + full cable replacement
LOC-01	SBC102-02/027	NEW CABLE ONLY	Duct	Full manhole-to-light cable replacement
LOC-01	TCCECH-03/035	NEW CABLE ONLY	Sawcut	Field sheet: sec. cable YES / shallow base NO — no coring, no dummy plate; full cable replacement via sawcut
LOC-01	TCCECH-03/018	NEW CABLE ONLY	Sawcut	Field sheet: sec. cable YES / shallow base NO — no coring, no dummy plate; full cable replacement via sawcut
LOC-01	TCC103-11/021	NOT ON FIELD SHEET — CONFIRM	—	Not listed on Document_3. Secondary route appears to cross the cut (2.0 m in cut) — confirm scope before works; no action assumed
LOC-01	TCC103-11/126	NOT ON FIELD SHEET — CONFIRM	—	Not listed on Document_3. Secondary route appears to cross the cut (2.0 m in cut) — confirm scope before works; no action assumed
LOC-01	TCC103-12/021	NOT ON FIELD SHEET — CONFIRM	—	Not listed on Document_3. Secondary route appears to cross the cut (2.0 m in cut) — confirm scope before works; no action assumed
LOC-01	TCC103-12/022	NOT ON FIELD SHEET — CONFIRM	—	Not listed on Document_3. Secondary route appears to cross the cut (7.8 m in cut) — confirm scope before works; no action assumed
LOC-01	SBC102-01/026	NOT AFFECTED		
LOC-02	TCCECH-03/007	NEW CABLE ONLY	Duct	Full manhole-to-light cable replacement
LOC-02	TCCECH-04/007	NEW CABLE ONLY	Duct	Full manhole-to-light cable replacement
LOC-02	TCCECH-03/008	NEW CABLE ONLY	Duct	Full manhole-to-light cable replacement
LOC-02	TCCECH-04/008	NEW CABLE ONLY	Duct	Full manhole-to-light cable replacement
LOC-02	TCCECH-03/009	NEW CABLE ONLY	Duct	Full manhole-to-light cable replacement
LOC-02	RRM.555	RRM REMOVE / PROTECT	—	Remove / protect before sawcut, re-fix after paving
LOC-03	SBC102-01/038	DUMMY PLATE + NEW CABLE	Sawcut	Base retained — fitting lifted, dummy plate fitted, full cable replacement
LOC-03	SBC102-01/039	DUMMY PLATE + NEW CABLE	Sawcut	Base retained — fitting lifted, dummy plate fitted, full cable replacement
LOC-03	SBC102-02/035	DUMMY PLATE + NEW CABLE	Sawcut	Base retained — fitting lifted, dummy plate fitted, full cable replacement
LOC-03	SBC102-02/036	DUMMY PLATE + NEW CABLE	Sawcut	Base retained — fitting lifted, dummy plate fitted, full cable replacement
LOC-03	SBC102-01/040	NEW CABLE ONLY	Duct	Full manhole-to-light cable replacement
LOC-03	SBC102-01/041	NEW CABLE ONLY	Duct	Full manhole-to-light cable replacement
LOC-03	SBC102-02/037	NEW CABLE ONLY	Duct	Full manhole-to-light cable replacement
LOC-03	SBC102-02/038	NEW CABLE ONLY	Duct	Full manhole-to-light cable replacement
LOC-03	TCCECH-03/002	NEW CABLE ONLY	Duct	Full manhole-to-light cable replacement
LOC-03	TCCECH-04/002	NEW CABLE ONLY	Duct	Full manhole-to-light cable replacement
LOC-03	TCCECH-03/003	NEW CABLE ONLY	Duct	Full manhole-to-light cable replacement
LOC-03	TCCECH-04/003	NEW CABLE ONLY	Duct	Full manhole-to-light cable replacement
LOC-03	RRM.557	RRM REMOVE / PROTECT	—	Remove / protect before sawcut, re-fix after paving
LOC-03	RRM.670	RRM REMOVE / PROTECT	—	Remove / protect before sawcut, re-fix after paving

CONSOLIDATED SCOPE TOTALS — TWY E (E4–E6)

1,887.3 m² Total demarcation area	11 Core-outs (LOC-01 only)	4 Dummy plates LOC-03 only · 4 TCC103 not counted	31 Secondary cable runs per field sheets; +4 TCC103	3 RRMs	1 Field-verified not affected
11 Saw-cut route runs LOC-01: 7 · LOC-03: 4 · +4 TCC103 not on field sheet · 13.8 m of secondary cable inside the cut			20 Duct route runs (secondary cable) LOC-01: 7 · LOC-02: 5 · LOC-03: 8 · existing duct, pulled manhole-to-light		

NOT ON FIELD SHEET — TCC103 (4 No.)

TCC103-11/021 — not listed; cable may cross cut (2.0 m) — confirm
 TCC103-11/126 — not listed; cable may cross cut (2.0 m) — confirm
 TCC103-12/021 — not listed; cable may cross cut (2.0 m) — confirm
 TCC103-12/022 — not listed; cable may cross cut (7.8 m) — confirm

DEMARCATIOn AREA BY LOCATION

LOC-01 (sheet 1001) — 572.6 m²
 LOC-02 (sheet 1002) — 700.3 m²
 LOC-03 (sheet 1003) — 614.4 m²

 Total — 1,887.3 m²