


SHOP DRAWINGS — ELECTRICAL / AGL SCOPE

RECTIFICATION OF TWY E BETWEEN E4 & E6 (ADIA)
AGL WORKS AT THREE (3) MILLING LOCATIONS — FIELD CONDITION SCOPE

Document No.	[XXX-ELE-SHD-1001 / 1002 / 1003] · Revision P06 (EDITABLE ISSUE)
Basis of scope	Field verification sheets: Document_3 (LOC-01) · Second_milling_area rev _1 (LOC-02/03) · Duct geometry: ADA drawing Z1-Z2-Z3-MTA_SEGMENTATION.dxf
Base layer	As-built AGL fitting positions (per assets_20260726120533.xlsx). AS PLOTTED they are ZIA LOCAL PROJECT GRID (m), matching the ADA source drawing to sub-millimetre — NOT UTM 40N. The Rev P05 EPSG:32640 label was incorrect — see sheet 6.
Prepared by	Mohammed — AGL Team Leader, ADB SAFEGATE AGL Team · Issued 28.07.2026

REV P06 — the "indicative duct" construction lines of Rev P05 (straight lines from each light to its nearest pit) are removed and replaced with the real as-built duct, ductbank, conduit and sawcut geometry from the ADA source drawing, registered onto each sheet to sub-millimetre. Every element remains a native editable PowerPoint shape. Provenance, registration residuals and limits: sheet 6.

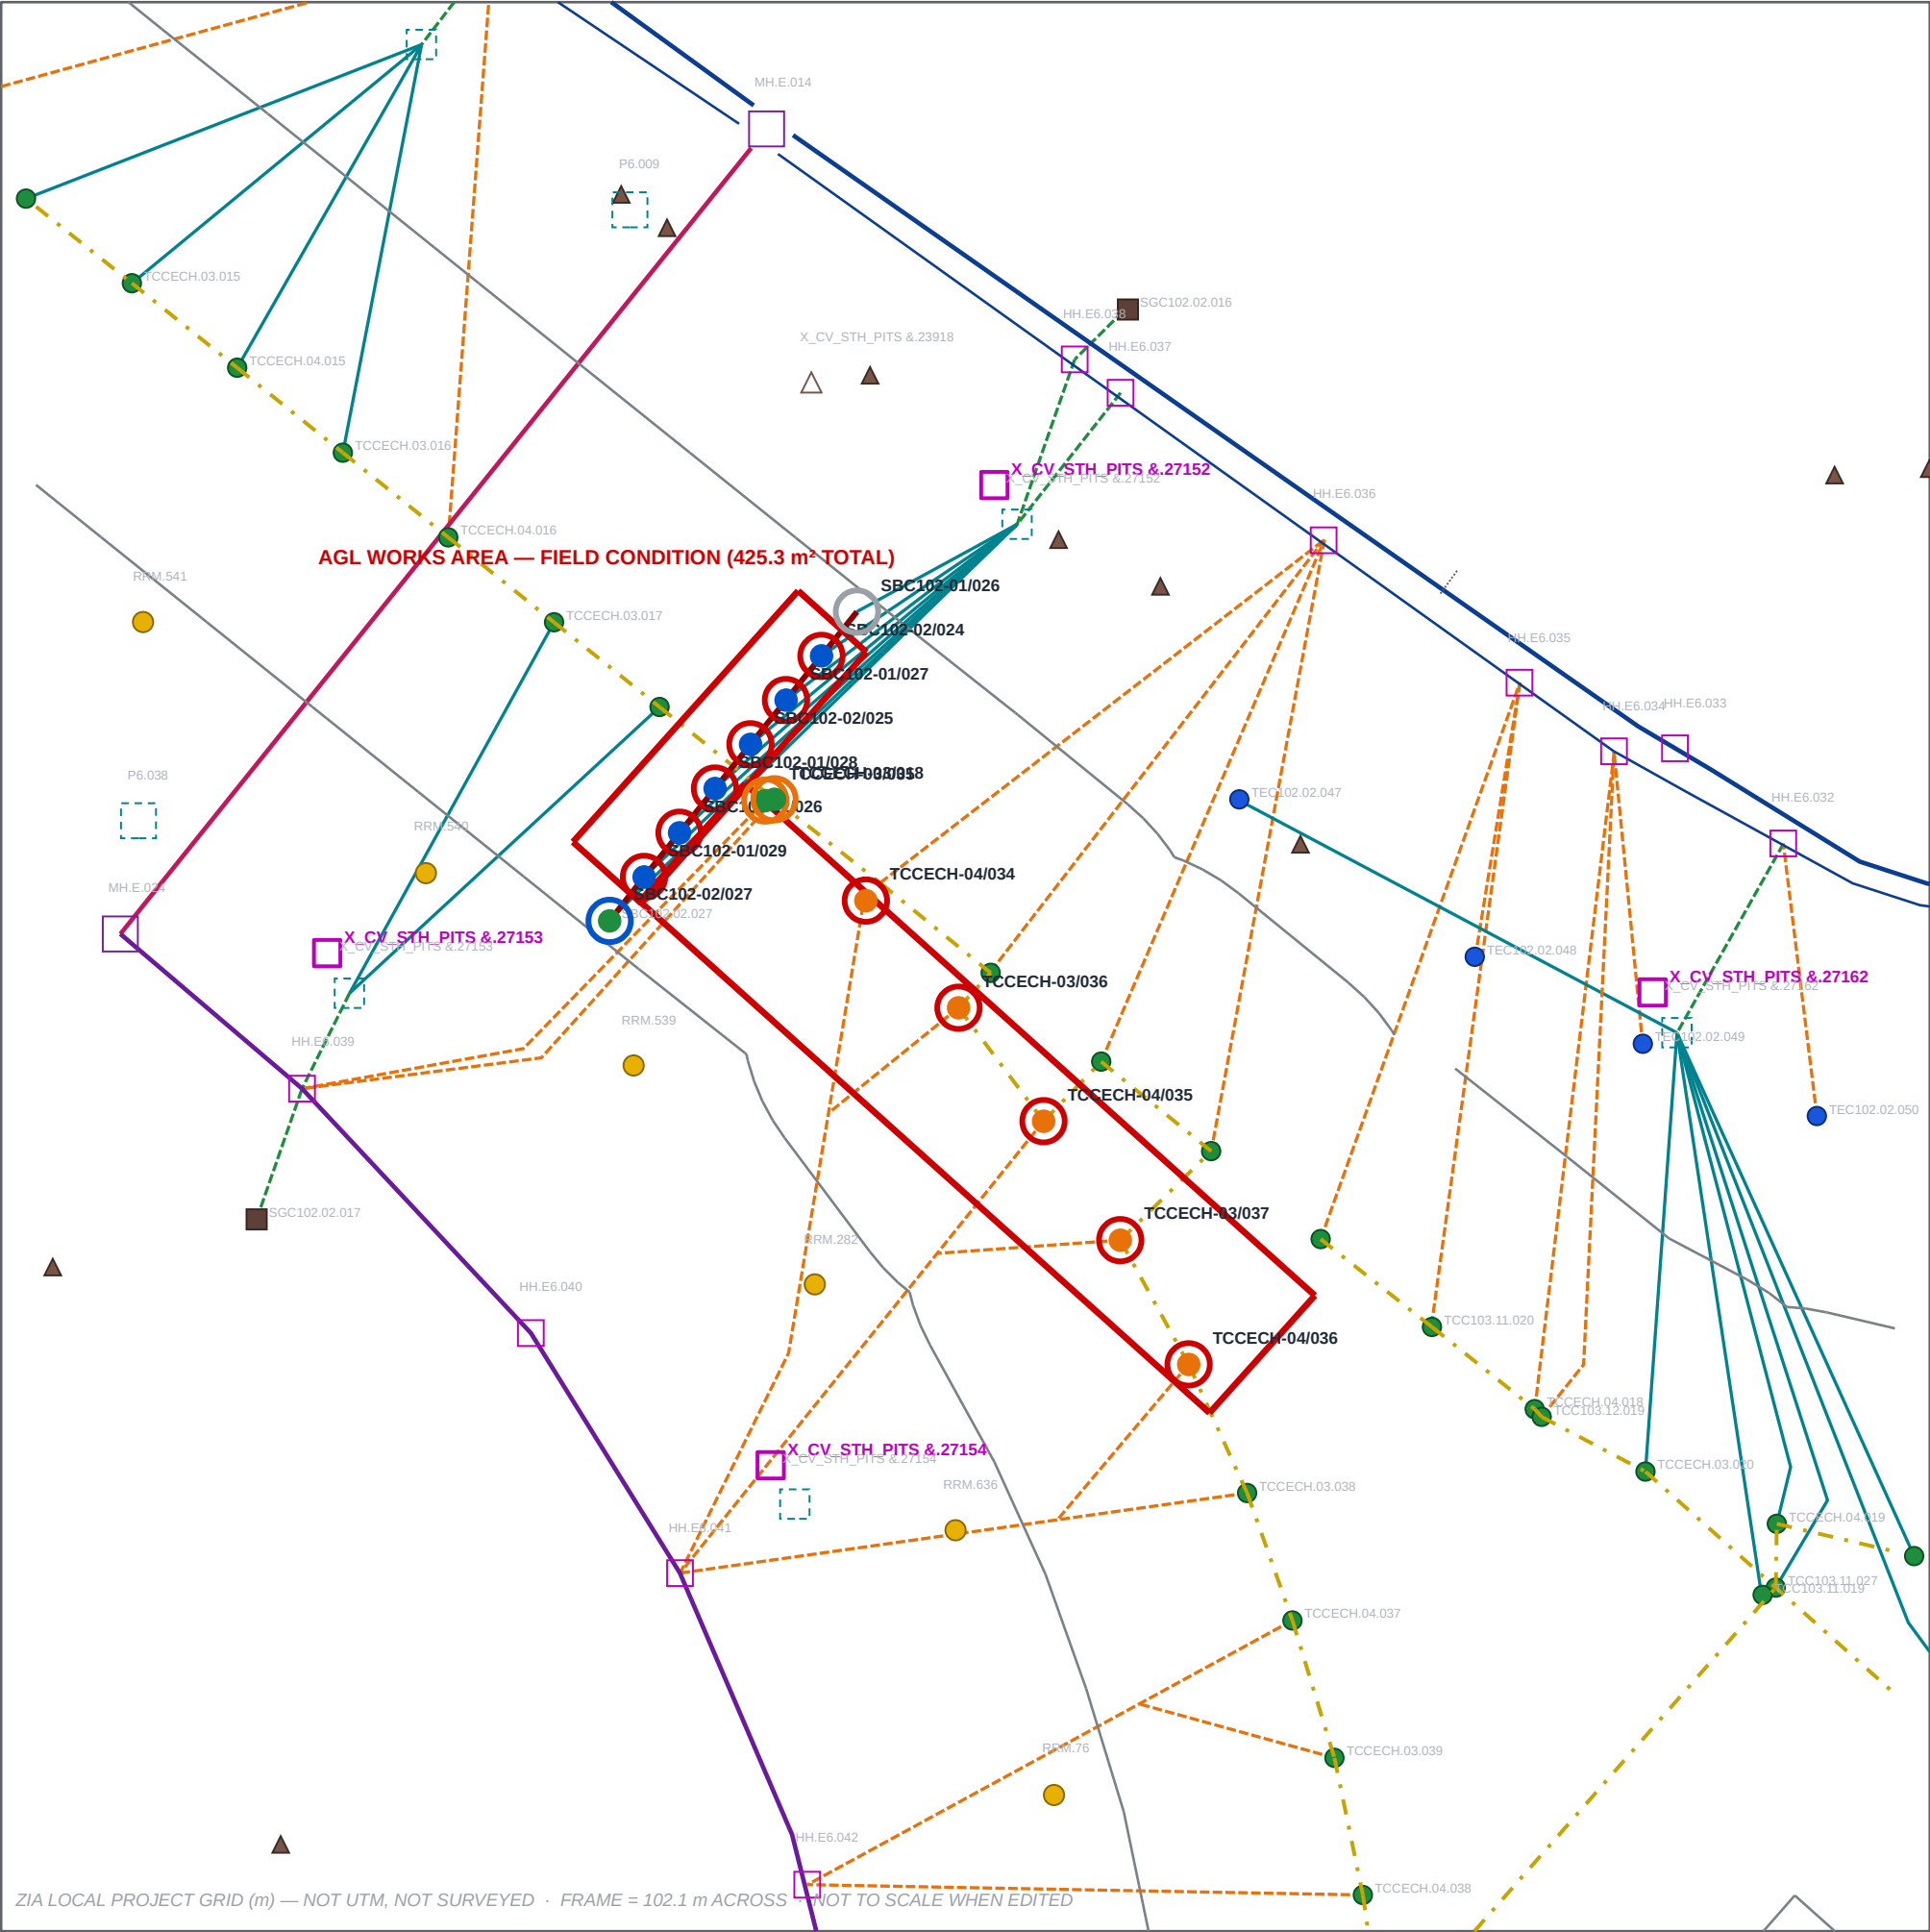

LOCATION 1 — 1001 · REV P06 (EDITABLE)

SCOPE PER FIELD SHEET Document_3 — FIELD CONDITION GOVERNS

Frame 102.1 m across · ZIA local grid (m) · duct geometry from Z1-Z2-Z3-MTA_SEGMENTATION source dwg · Rev P06 · Prepared: Mohammed, AGL Team Leader — ADB SAFEGATE

SCOPE / QUANTITIES (PER FIELD VERIFICATION)


CORE OUT SHALLOW BASE + NEW CABLE: 11 No.
• VIA DUCT (6): SBC102-02/024, 01/027, 02/025, 01/028, 02/026, 01/029
• VIA SAWCUT (5): TCCECH-04/034, 03/036, 04/035, 03/037, 04/036
NEW SECONDARY CABLE ONLY: 3 No.
• SBC102-02/027 (DUCT) · TCCECH-03/035, 03/018 (SAWCUT — bases OK, verify at cut line)
FIELD VERIFIED NOT AFFECTED: SBC102-01/026 (no works)
TCC103 FITTINGS NOT IN FIELD SCOPE — SHOWN AS EXISTING ONLY
ISOLATE CIRCUITS: SBC102.01/.02, TCCECH.03/.04
SITE RECORD 23.07.2026: 9 cored + 2 reinstatement already worked

GENERAL NOTES

- Positions plotted are ZIA LOCAL PROJECT GRID metres — NOT UTM 40N. The Rev P06 "EPSG:32640" label was wrong; no surveyed local-to-UTM transform exists. Do not issue a UTM coordinate from this sheet.
- AGL works area (red) per field condition. Coring at Location 1 only.
- Duct / ductbank / conduit / sawcut lines are REAL as-built geometry from ADA drawing Z1-Z2-Z3-MTA_SEGMENTATION.dxf — not light-to-nearest-pit construction lines. Layer name carries size and way-count; see sheet 6.
- Ducts are drawn as the separate segments they are in the source. Continuity NOT proven — do not take a continuous pull length off this sheet.
- Isolate, lock out & prove dead all listed circuits at CCR under permit before cutting, coring or excavation.
- HH / MH / transformer-pit / RRM symbols sit ~2.1-2.3 m off the source insertion point (sheet 6) — set out civil features from survey.
- Centerline & stop bar from as-built TCC / SBC fittings. Edge indicative 23 m — confirm on site.
- Every asset in frame carries its own as-built symbol, legended right. Type comes from the source layer, not the label. Assets with a works-action marker keep that marker.

LEGEND — THIS SHEET

WORKS ACTIONS & LINEWORK	AS-BUILT AGL ASSETS
CORE OUT + NEW CABLE (DUCT)	TWY CENTRELINE LIGHT (31)
CORE OUT + NEW CABLE (SAWCUT)	TWY EDGE LIGHT (4)
NEW SEC. CABLE ONLY (DUCT)	STOP BAR LIGHT (8)
NEW SEC. CABLE ONLY (SAWCUT)	RUNWAY GUARD LIGHT / RRM (6)
FIELD VERIFIED — NOT AFFECTED	SIGN FOUNDATION (2)
AS-BUILT DUCT / DUCTBANK 4×110 · 6×110	HANDHOLE (HH) (11)
AS-BUILT SECONDARY CONDUIT	TRANSFORMER HH (SEC. FEED HUB) (5)
AGL WORKS AREA (GOVERNING)	MANHOLE (MH) (2)
TAXIWAY CENTRELINE (AS-BUILT)	TRANSFORMER MH (SEC. FEED) (2)
STOP BAR (AS-BUILT)	EARTHING POINT (10)
TWY EDGE / PAVEMENT (INDICATIVE 23 m)	EARTHING PIT (1)

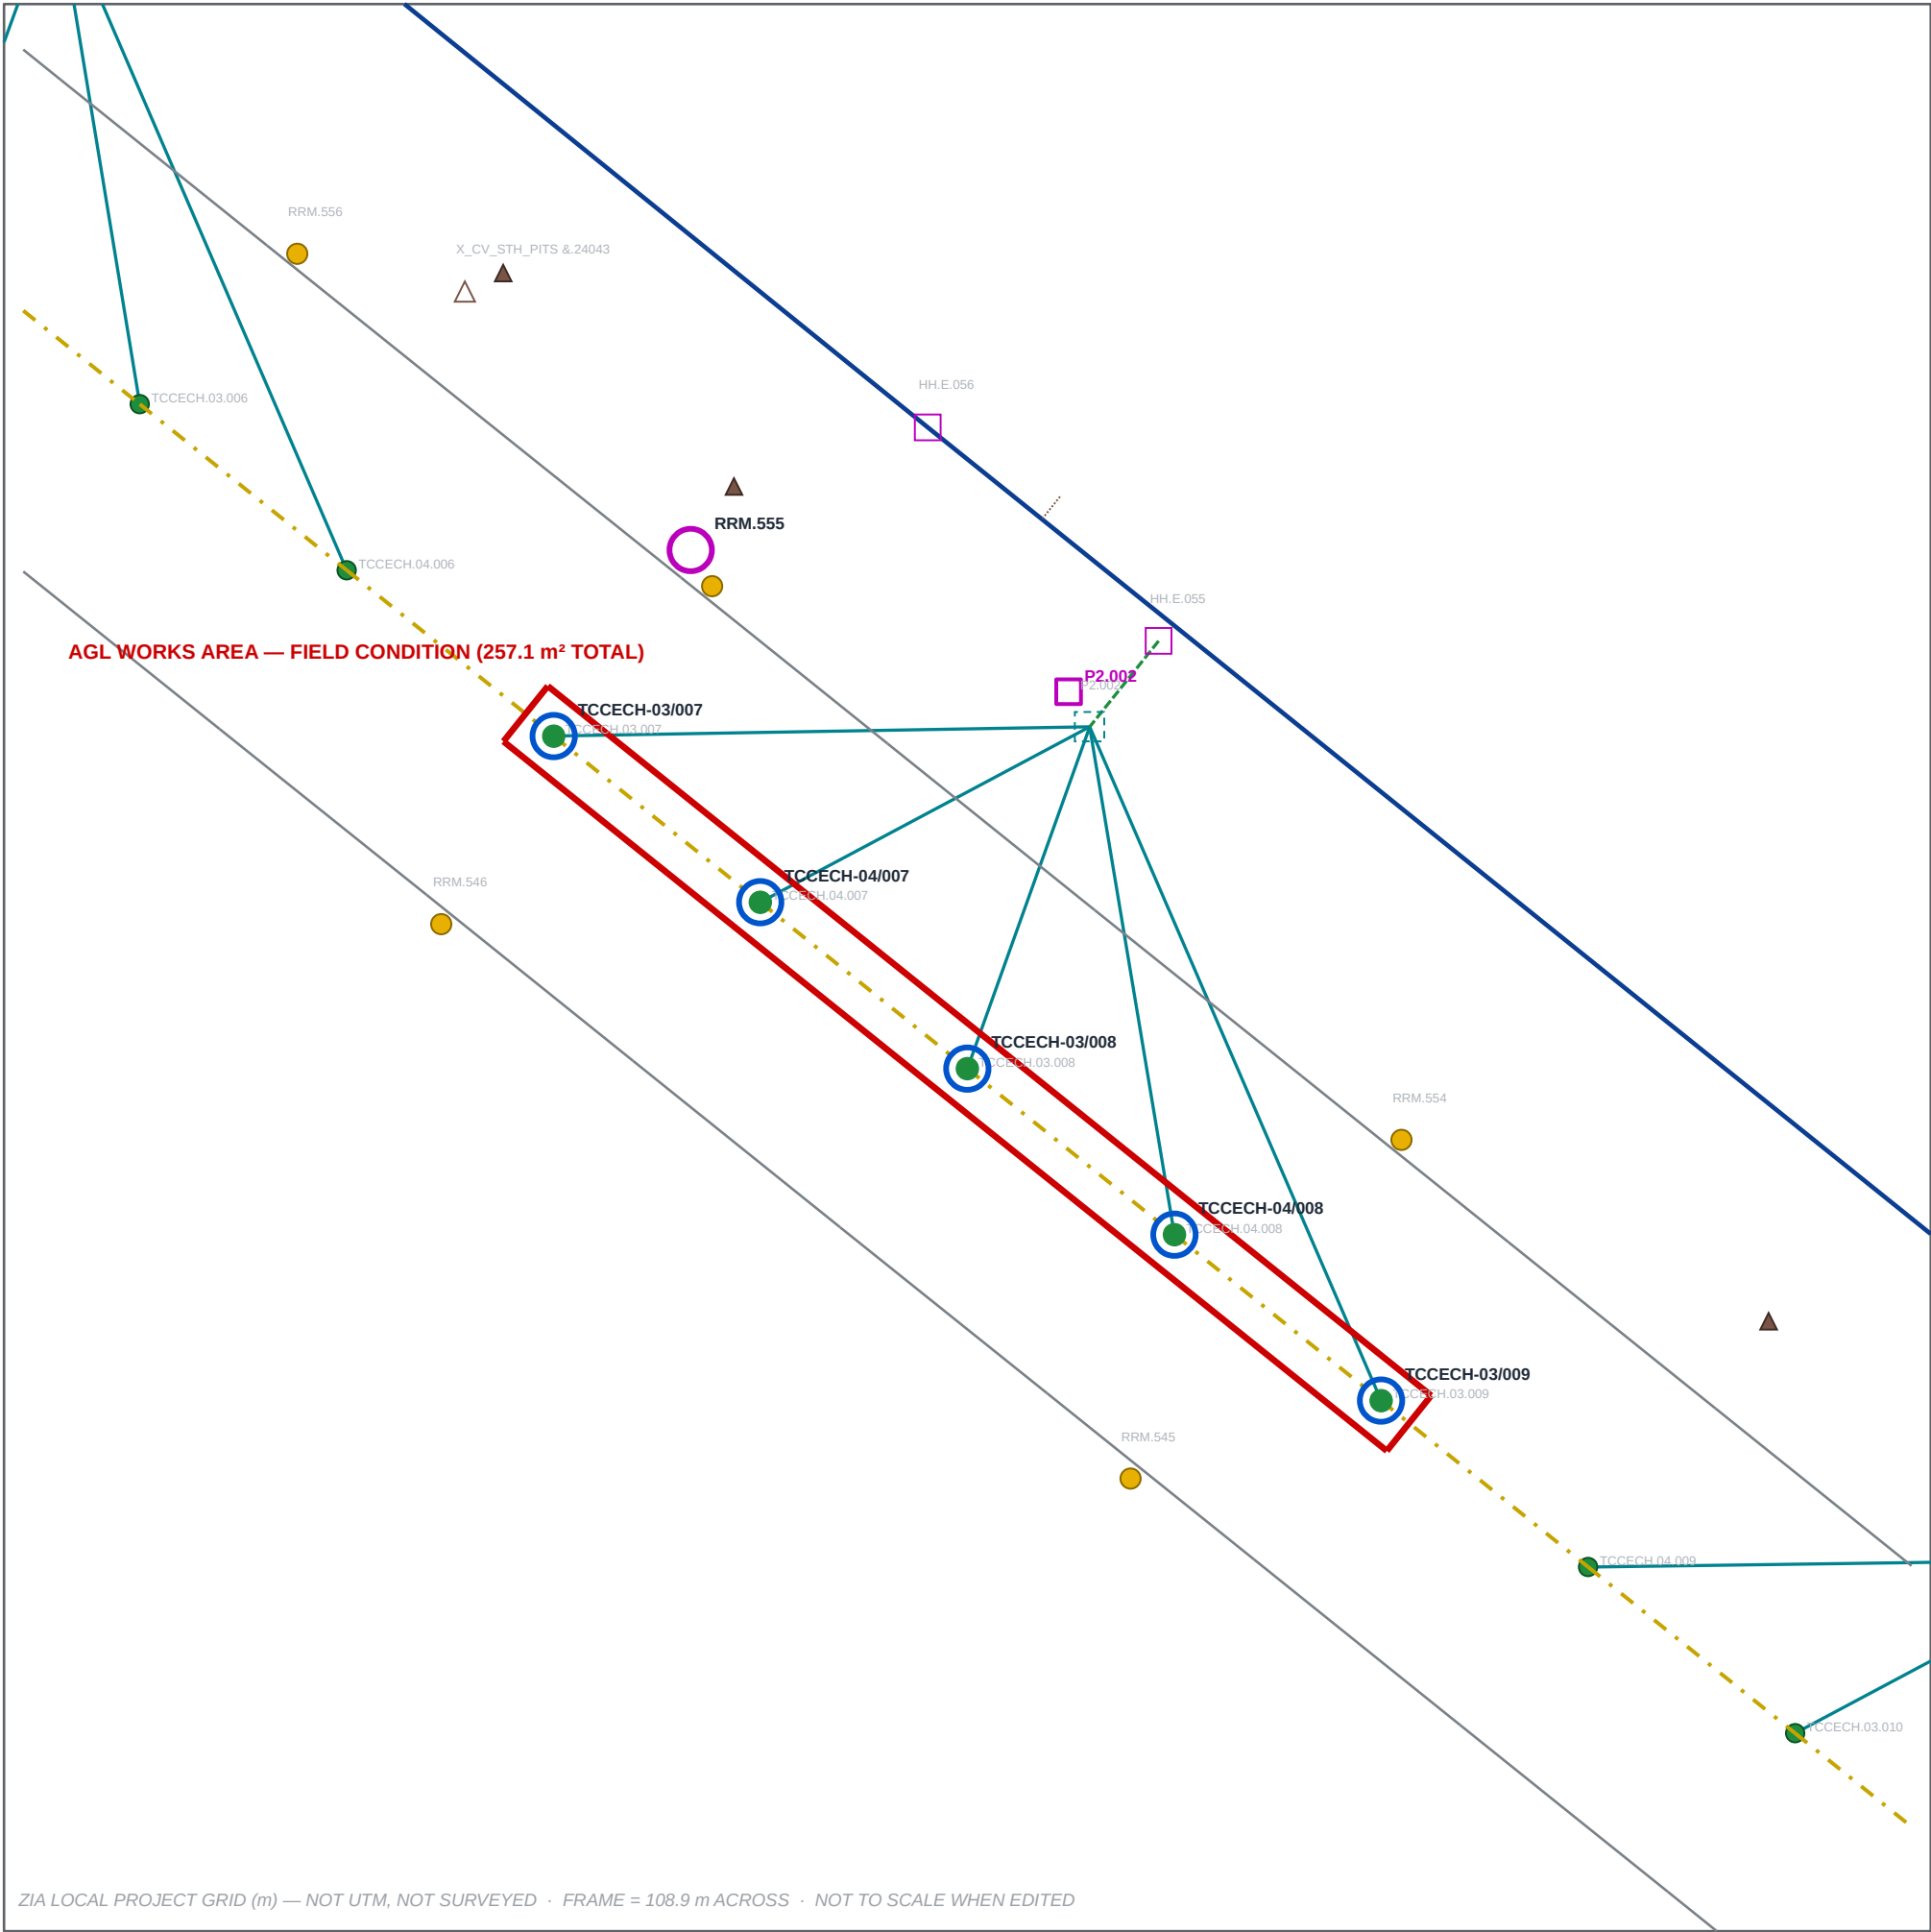

ZIA LOCAL PROJECT GRID (m) — NOT UTM, NOT SURVEYED · FRAME = 108.9 m ACROSS · NOT TO SCALE WHEN EDITED

LOCATION 2 — 1002 · REV P06 (EDITABLE)

SCOPE PER FIELD SHEET Second_milling_area rev _1 — FIELD CONDITION GOVERNS

Frame 108.9 m across · ZIA local grid (m) · duct geometry from Z1-Z2-Z3-MTA_SEGMENTATION source dwg · Rev P06 · Prepared: Mohammed, AGL Team Leader — ADB SAFEGATE

SCOPE / QUANTITIES (PER FIELD VERIFICATION)

NEW SECONDARY CABLE ONLY (VIA DUCT): 5 No.
• TCCECH-03/007, 04/007, 03/008, 04/008, 03/009
NO SHALLOW BASES AFFECTED AT THIS LOCATION
SECONDARY DUCT (AS-BUILT): 5 SEPARATE HOME RUNS FROM ONE TRANSFORMER
HANDHOLE — NOT A CHAINED RUN. 20.5 / 21.1 / 29.1 / 30.3 / 41.5 m = 142.5 m TOTAL. RE-PRICE — SEE SHEET 7.
(Rev P06 chained-run assumption superseded by the source drawing — see sheet 7)
RRM.555 (0.41 m from cut): REMOVE / PROTECT BEFORE SAWCUT, RE-FIX AFTER PAVING
ISOLATE CIRCUITS: TCCECH.03, TCCECH.04

GENERAL NOTES

- Positions plotted are ZIA LOCAL PROJECT GRID metres — NOT UTM 40N. The Rev P06 "EPSG:32640" label was wrong; no surveyed local-to-UTM transform exists. Do not issue a UTM coordinate from this sheet.
- AGL works area (red) per field condition. Coring at Location 1 only.
- Duct / ductbank / conduit / sawcut lines are REAL as-built geometry from ADA drawing Z1-Z2-Z3-MTA_SEGMENTATION.dxf — not light-to-nearest-pit construction lines. Layer name carries size and way-count; see sheet 6.
- Ducts are drawn as the separate segments they are in the source. Continuity NOT proven — do not take a continuous pull length off this sheet.
- Isolate, lock out & prove dead all listed circuits at CCR under permit before cutting, coring or excavation.
- HH / MH / transformer-pit / RRM symbols sit ~2.1-2.3 m off the source insertion point (sheet 6) — set out civil features from survey.
- Centerline & stop bar from as-built TCC / SBC fittings. Edge indicative 23 m — confirm on site.
- Every asset in frame carries its own as-built symbol, legended right. Type comes from the source layer, not the label. Assets with a works-action marker keep that marker.


LEGEND — THIS SHEET

WORKS ACTIONS & LINEWORK

- NEW SEC. CABLE ONLY (DUCT)
- RRM — REMOVE / PROTECT / RE-FIX
- AS-BUILT DUCT / DUCTBANK 4×110 · 6×110
- AS-BUILT SECONDARY CONDUIT
- AGL WORKS AREA (GOVERNING)
- TAXIWAY CENTRELINE (AS-BUILT)
- TWY EDGE / PAVEMENT (INDICATIVE 23 m)

AS-BUILT AGL ASSETS

- TWY CENTRELINE LIGHT (9)
- RUNWAY GUARD LIGHT / RRM (5)
- HANDHOLE (HH) (2)
- TRANSFORMER HH (SEC. FEED HUB) (1)
- EARTHING POINT (3)
- EARTHING PIT (1)

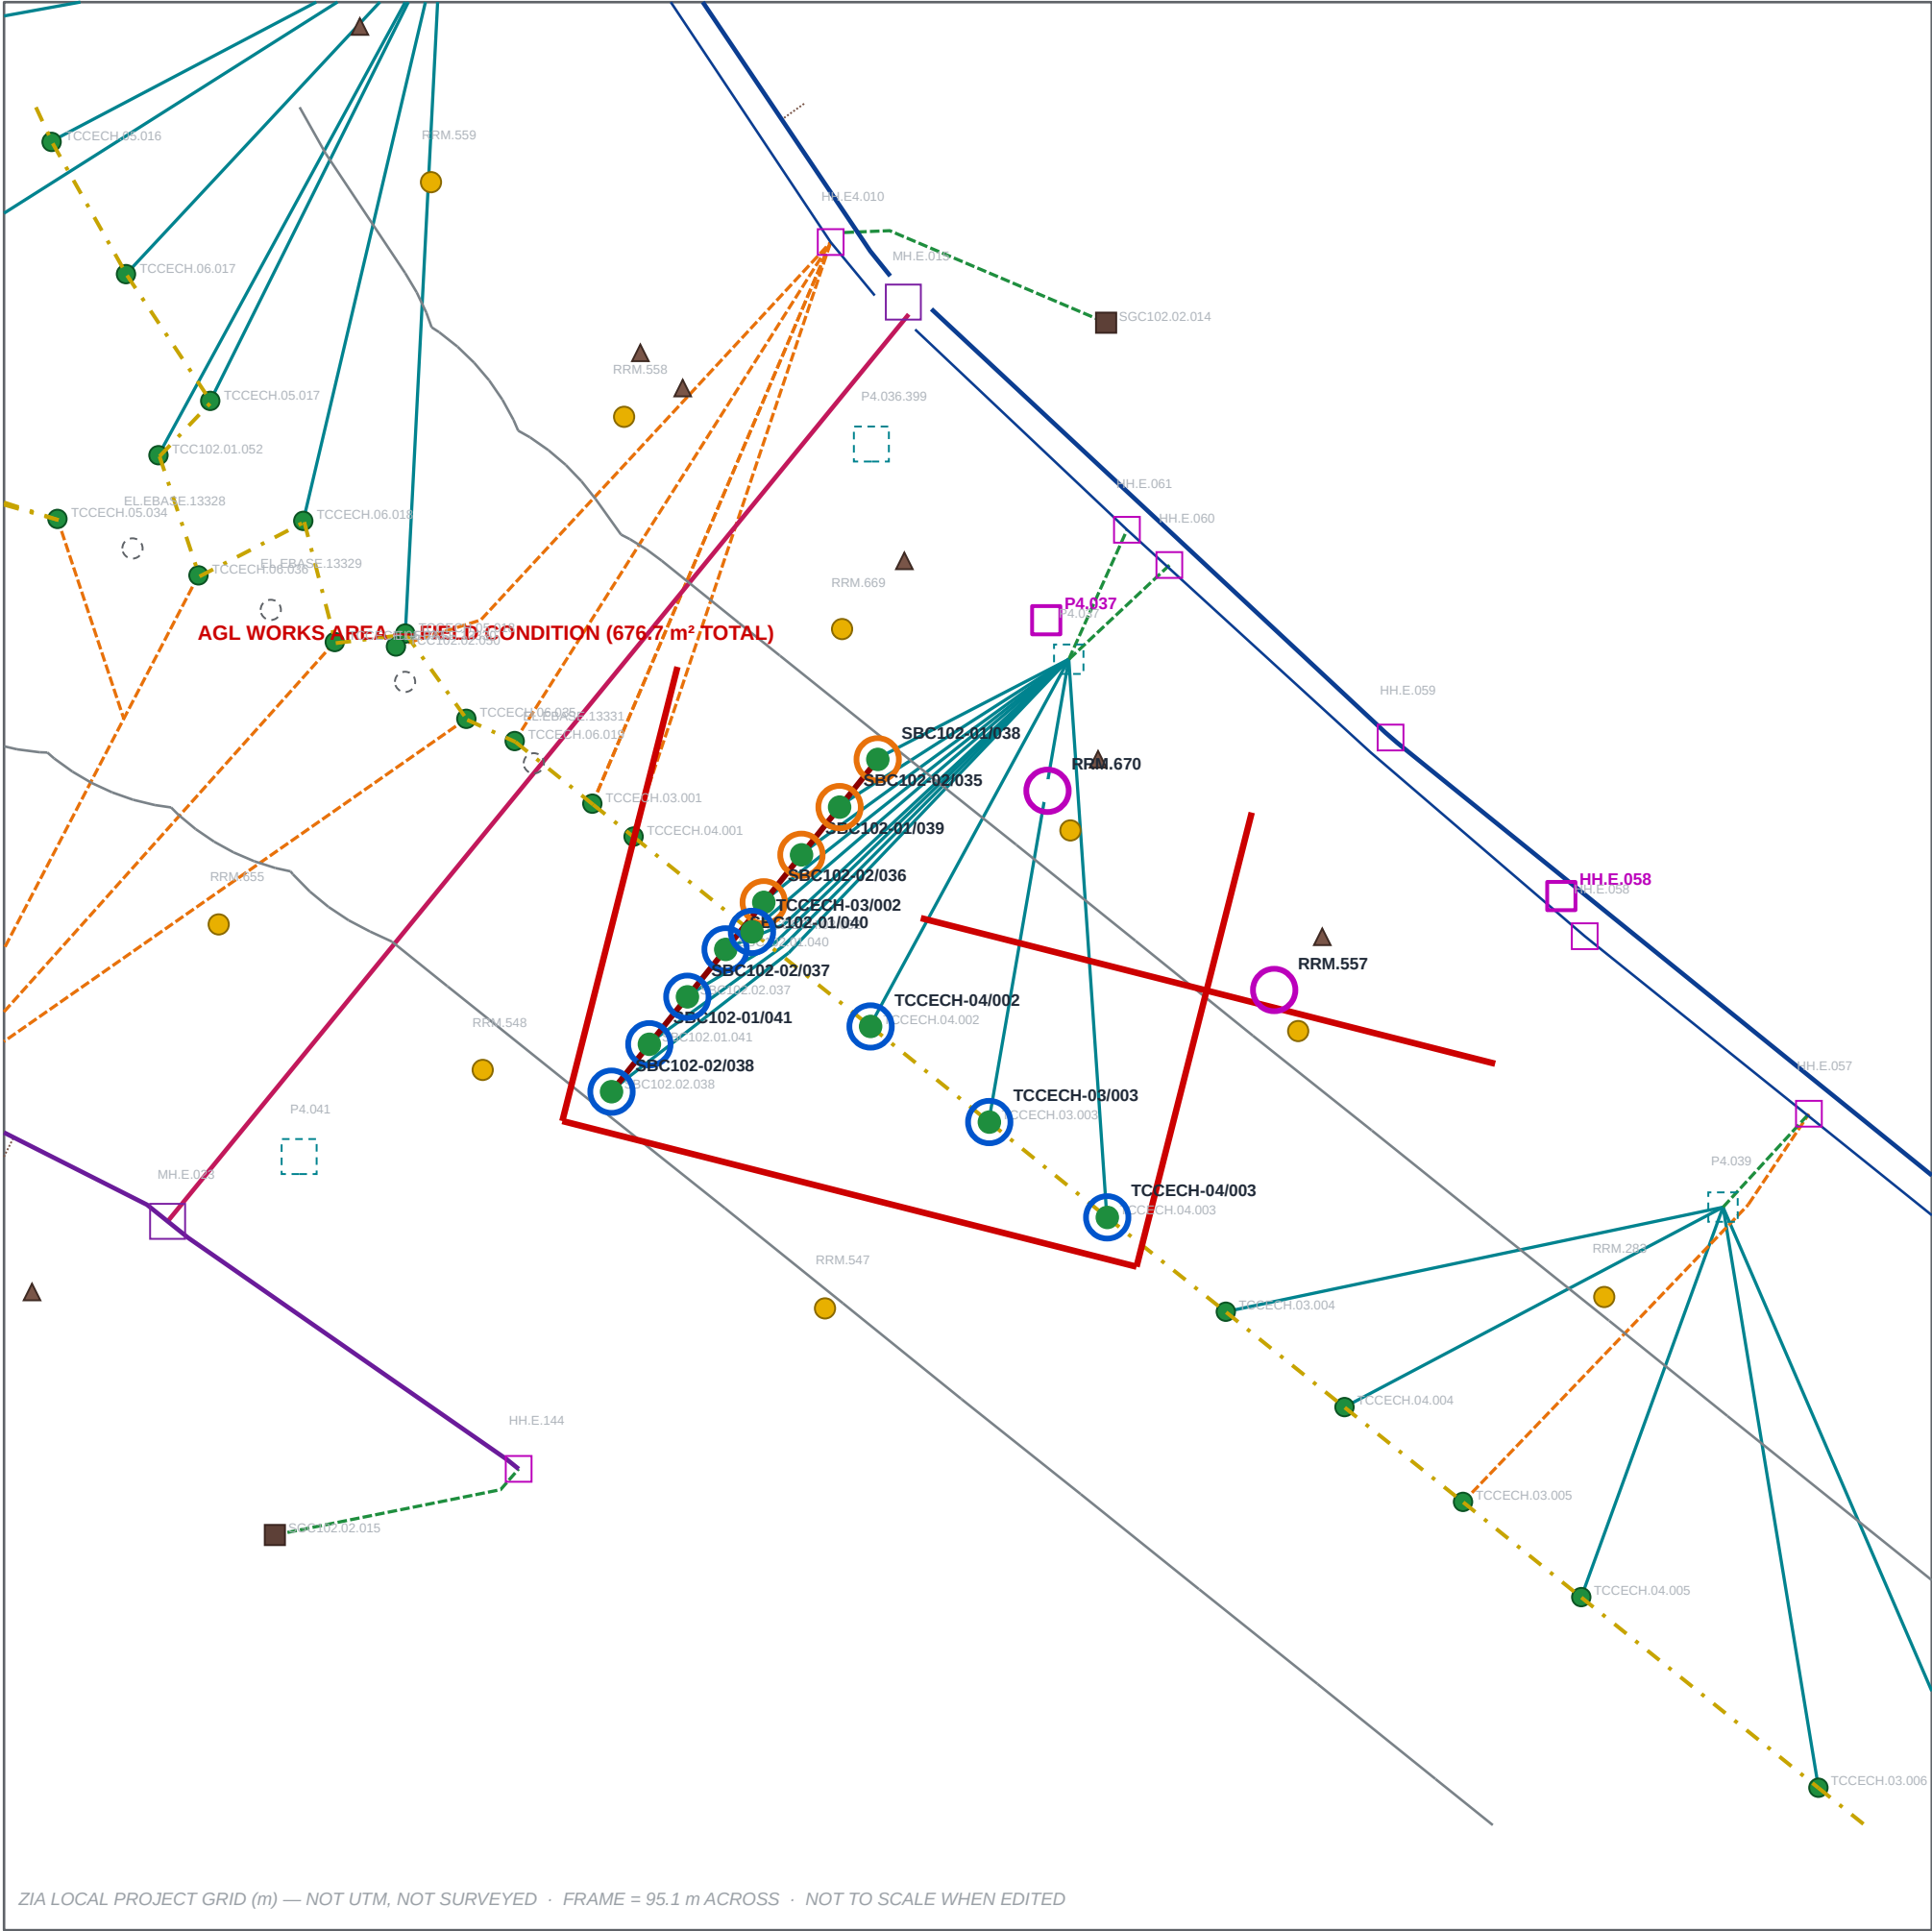

LOCATION 3 — 1003 · REV P06 (EDITABLE)

SCOPE PER FIELD SHEET Second_milling_area rev _1 — FIELD CONDITION GOVERNS (rev _1 supersedes earlier all-NO rev)

Frame 95.1 m across · ZIA local grid (m) · duct geometry from Z1-Z2-Z3-MTA_SEGMENTATION source dwg · Rev P06 · Prepared: Mohammed, AGL Team Leader — ADB SAFEGATE

SCOPE / QUANTITIES (PER FIELD VERIFICATION)

NO CORING AT THIS LOCATION — SECONDARY CABLES ONLY (12 RUNS)
NEW CABLE VIA SAWCUT: 4 No. — SBC102-01/038, 01/039, 02/035, 02/036
(EP7 STOP BAR — bases per field rev _1: remove fitting & protect base, NO coring)
NEW SECONDARY CABLE ONLY (VIA DUCT): 8 No.
• SBC102-01/040, 01/041, 02/037, 02/038, TCCECH-03/002, 04/002, 03/003, 04/003
RRM.557 (0.07 m — treat as within works) & RRM.670: REMOVE / PROTECT / RE-FIX
ISOLATE CIRCUITS: SBC102.01/02, TCCECH.03/04

GENERAL NOTES

- Positions plotted are ZIA LOCAL PROJECT GRID metres — NOT UTM 40N. The Rev P06 "EPSG:32640" label was wrong; no surveyed local-to-UTM transform exists. Do not issue a UTM coordinate from this sheet.
- AGL works area (red) per field condition. Coring at Location 1 only.
- Duct / ductbank / conduit / sawcut lines are REAL as-built geometry from ADA drawing Z1-Z2-Z3-MTA_SEGMENTATION.dxf — not light-to-nearest-pit construction lines. Layer name carries size and way-count; see sheet 6.
- Ducts are drawn as the separate segments they are in the source. Continuity NOT proven — do not take a continuous pull length off this sheet.
- Isolate, lock out & prove dead all listed circuits at CCR under permit before cutting, coring or excavation.
- HH / MH / transformer-pit / RRM symbols sit ~2.1-2.3 m off the source insertion point (sheet 6) — set out civil features from survey.
- Centerline & stop bar from as-built TCC / SBC fittings. Edge indicative 23 m — confirm on site.
- Every asset in frame carries its own as-built symbol, legended right. Type comes from the source layer, not the label. Assets with a works-action marker keep that marker.

LEGEND — THIS SHEET

WORKS ACTIONS & LINEWORK	AS-BUILT AGL ASSETS
NEW SEC. CABLE ONLY (SAWCUT)	TWY CENTRELINE LIGHT (23)
NEW SEC. CABLE ONLY (DUCT)	STOP BAR LIGHT (8)
RRM — REMOVE / PROTECT / RE-FIX	RUNWAY GUARD LIGHT / RRM (9)
AS-BUILT DUCT / DUCTBANK 4×110 · 6×110	EXISTING LIGHT BASE (NO FITTING) (4)
AS-BUILT SECONDARY CONDUIT	SIGN FOUNDATION (2)
AGL WORKS AREA (GOVERNING)	HANDHOLE (HH) (7)
TAXIWAY CENTRELINE (AS-BUILT)	TRANSFORMER HH (SEC. FEED HUB) (2)
STOP BAR (AS-BUILT)	MANHOLE (MH) (2)
TWY EDGE / PAVEMENT (INDICATIVE 23 m)	TRANSFORMER MH (SEC. FEED) (2)
	EARTHING POINT (7)

CONSOLIDATED FIELD-GOVERNED SCOPE — TWY E (E4–E6) · REV P06

Loc	Asset	Works Action	Route	Remarks
LOC-01	SBC102-02/024	CORE OUT + NEW CABLE	Duct	Core out shallow base + full cable replacement
LOC-01	SBC102-01/027	CORE OUT + NEW CABLE	Duct	Core out shallow base + full cable replacement
LOC-01	SBC102-02/025	CORE OUT + NEW CABLE	Duct	Core out shallow base + full cable replacement
LOC-01	SBC102-01/028	CORE OUT + NEW CABLE	Duct	Core out shallow base + full cable replacement
LOC-01	SBC102-02/026	CORE OUT + NEW CABLE	Duct	Core out shallow base + full cable replacement
LOC-01	SBC102-01/029	CORE OUT + NEW CABLE	Duct	Core out shallow base + full cable replacement
LOC-01	TCCECH-04/034	CORE OUT + NEW CABLE	Sawcut	Core out shallow base + full cable replacement
LOC-01	TCCECH-03/036	CORE OUT + NEW CABLE	Sawcut	Core out shallow base + full cable replacement
LOC-01	TCCECH-04/035	CORE OUT + NEW CABLE	Sawcut	Core out shallow base + full cable replacement
LOC-01	TCCECH-03/037	CORE OUT + NEW CABLE	Sawcut	Core out shallow base + full cable replacement
LOC-01	TCCECH-04/036	CORE OUT + NEW CABLE	Sawcut	Core out shallow base + full cable replacement
LOC-01	SBC102-02/027	NEW CABLE ONLY	Duct	Full manhole-to-light cable replacement
LOC-01	TCCECH-03/035	NEW CABLE ONLY	Sawcut	Full manhole-to-light cable replacement
LOC-01	TCCECH-03/018	NEW CABLE ONLY	Sawcut	Full manhole-to-light cable replacement
LOC-01	SBC102-01/026	NOT AFFECTED	—	Field verified — no works
LOC-02	TCCECH-03/007	NEW CABLE ONLY	Duct	Full manhole-to-light cable replacement
LOC-02	TCCECH-04/007	NEW CABLE ONLY	Duct	Full manhole-to-light cable replacement
LOC-02	TCCECH-03/008	NEW CABLE ONLY	Duct	Full manhole-to-light cable replacement
LOC-02	TCCECH-04/008	NEW CABLE ONLY	Duct	Full manhole-to-light cable replacement
LOC-02	TCCECH-03/009	NEW CABLE ONLY	Duct	Full manhole-to-light cable replacement
LOC-02	RRM.555	RRM REMOVE / PROTECT	—	Remove / protect before sawcut, re-fix after paving
LOC-03	SBC102-01/038	NEW CABLE ONLY	Sawcut	Full manhole-to-light cable replacement
LOC-03	SBC102-01/039	NEW CABLE ONLY	Sawcut	Full manhole-to-light cable replacement
LOC-03	SBC102-02/035	NEW CABLE ONLY	Sawcut	Full manhole-to-light cable replacement
LOC-03	SBC102-02/036	NEW CABLE ONLY	Sawcut	Full manhole-to-light cable replacement
LOC-03	SBC102-01/040	NEW CABLE ONLY	Duct	Full manhole-to-light cable replacement
LOC-03	SBC102-01/041	NEW CABLE ONLY	Duct	Full manhole-to-light cable replacement
LOC-03	SBC102-02/037	NEW CABLE ONLY	Duct	Full manhole-to-light cable replacement
LOC-03	SBC102-02/038	NEW CABLE ONLY	Duct	Full manhole-to-light cable replacement
LOC-03	TCCECH-03/002	NEW CABLE ONLY	Duct	Full manhole-to-light cable replacement
LOC-03	TCCECH-04/002	NEW CABLE ONLY	Duct	Full manhole-to-light cable replacement
LOC-03	TCCECH-03/003	NEW CABLE ONLY	Duct	Full manhole-to-light cable replacement
LOC-03	TCCECH-04/003	NEW CABLE ONLY	Duct	Full manhole-to-light cable replacement
LOC-03	RRM.557	RRM REMOVE / PROTECT	—	Remove / protect before sawcut, re-fix after paving
LOC-03	RRM.670	RRM REMOVE / PROTECT	—	Remove / protect before sawcut, re-fix after paving

SHEET 6 — DUCT PROVENANCE & REGISTRATION VERIFICATION · TWY E (E4-E6) REV P06

1 · SOURCE OF THE DUCT GEOMETRY

Drawing: Z1-Z2-Z3-MTA_SEGMENTATION.dxf, issued by Abu Dhabi Airports. AC1032 (AutoCAD 2018), \$INSUNITS = 6 (metres), 549 MB, 2,564 layers, 12 model-space xrefs all inserted at (0,0,0), scale 1, rotation 0.
Extracted population: 33,720 fixture INSERTs and 49,505 linear features (1,878 km), of which 17,101 features / 466 km are duct, ductbank, conduit, sawcut or secondary cable.
Duct type, bore and way-count are read from the layer name — that is the only place the drawing records them (e.g. CV_OUTER DUCT 4x110mm dia).
Extraction is reconciled against an independent per-layer entity census; every count above is asserted by an automated check, not read off by eye.

2 · HOW SHEETS 2-4 WERE TIED TO THE SOURCE DRAWING

The sheets carry no coordinate grid, so each was registered to the source drawing by matching the plotted AGL fitting pattern: type-matched 2-point RANSAC to find the correspondence, then a 4-parameter Helmert fit (translation, rotation, uniform scale) by least squares — not an affine, which would hide error as fake shear. Half the matched pairs were held back from the fit; the hold-out RMS below is the accuracy figure.

Sheet	Fitting symbols in frame	Matched to source within 50 mm	Fit RMS	HOLD-OUT RMS (pairs never fitted)	Plotted scale	Frame on ground
LOC-01	64	37	0.4 mm	0.40 mm on 14	93,614 EMU/m	102.1 m
LOC-02	18	9	0.3 mm	0.46 mm on 4	87,716 EMU/m	108.9 m
LOC-03	59	11	58.2 mm	0.49 mm on 13	100,476 EMU/m	95.1 m

Rotation solved to +0.0001° / −0.000001° / +0.0027° and the y axis is mirrored — i.e. the sheets are plotted axis-aligned to the grid.
Independent check: the deck's own "as-built taxiway centreline" polyline, never used in the fit, lands on source centreline fixtures at 0.3–0.4 mm median on LOC-01/02.

3 · FINDING — THE Rev P05 COORDINATE LABEL WAS WRONG

Rev P05 sheets state "UTM 40N (EPSG:32640) — AS-BUILT POSITIONS". They are not UTM. The plotted positions are ZIA local project grid metres (X ≈ 5,800–6,200, Y ≈ 54,400–54,700). UTM 40N here would read easting ~230,000–800,000 and northing ~2,650,000–2,750,000.
The source drawing carries no GEODATA object and no georeferencing of any kind, so no local→UTM transform can be derived from it. Rev P06 sheets are relabelled accordingly.
Consequence: any coordinate previously issued from Rev P05 as UTM — to ADA, Injaz or a contractor — needs withdrawing and re-checking against survey control.

5 · LIMITS — READ BEFORE USING THIS GEOMETRY

- a) Runs are fragments, not proven pulls. The duct lines are the individual LINE / LWPOLYLINE segments as drafted. No endpoint snapping or graph chaining has been done, so "handhole A to handhole B" is not established. Do not order cable to a length scaled off these sheets.
- b) Coordinates are ZIA local grid, not surveyed and not UTM. Nothing here may be issued as a setting-out coordinate without an externally checked transform against ADA survey control.
- c) Civil symbols are ~2.1–2.3 m off. Handhole, manhole, transformer-pit and RRM symbols on the sheets sit a mean 2.1–2.3 m (sd 0.3–0.45 m) from the source-drawing insertion point, while AGL light fittings match to sub-millimetre. Set out civil features from survey, not from these sheets.
- d) Per-asset route attribution is NOT given. The consolidated table's "Route" column is unchanged from Rev P05. Attributing a specific duct layer to a named asset was attempted and rejected: the sheets' labels sit 3–8 m from their markers with neighbours only 10–15% further, and several markers resolve to the same label, so the assignment cannot be made from the drawing alone. It needs the source asset register, which is not in this data set.
- e) Z values are unreliable in the source drawing. This is a 2D basemap only; take levels from survey.
- f) Elements outside the twelve identity-inserted xrefs were excluded rather than drawn in the wrong place (3,375 geometry entities, 2,409 nested fixtures drawing-wide). If a duct looks absent in a given corner, check this first.

4 · DUCT SCHEDULE — WHAT IS DRAWN ON EACH SHEET

LOC-01 — 59 segments, 1433 m inside the frame

Source layer (carries bore & way-count)	Draw	Segs	On sheet
CV-NEW SEC SAWCUT		23	606.7 m
CV-EX SEC CONDUIT		21	490.9 m
CV_INNER DUCT 4x110mm dia		3	84.6 m
CV_OUTER DUCT 4x110mm dia		2	81.5 m
CV_STH DUCT 6x110mm dia		1	65.6 m
CV_DUCT CROSSING 6x110mm dia		1	53.3 m
CV-NEW SEC CONDUIT		7	49.0 m
CV_GRND DUCT		1	1.5 m


LOC-02 — 13 segments, 349 m inside the frame

Source layer (carries bore & way-count)	Draw	Segs	On sheet
CV-EX SEC CONDUIT		10	230.7 m
CV_OUTER DUCT 4x110mm dia		1	110.8 m
CV-NEW SEC CONDUIT		1	6.2 m
CV_GRND DUCT		1	1.6 m

LOC-03 — 53 segments, 1104 m inside the frame

Source layer (carries bore & way-count)	Draw	Segs	On sheet
CV-EX SEC CONDUIT		29	541.5 m
CV-NEW SEC SAWCUT		11	259.1 m
CV_INNER DUCT 4x110mm dia		2	84.2 m
CV_OUTER DUCT 4x110mm dia		2	81.7 m
CV_DUCT CROSSING 6x110mm dia		1	57.8 m
CV-NEW SEC CONDUIT		5	46.6 m
CV_STH DUCT 6x110mm dia		1	30.4 m
CV_GRND DUCT		2	2.4 m

6 · THE GEOMETRY, IN THE SOURCE DRAWING'S OWN GRID

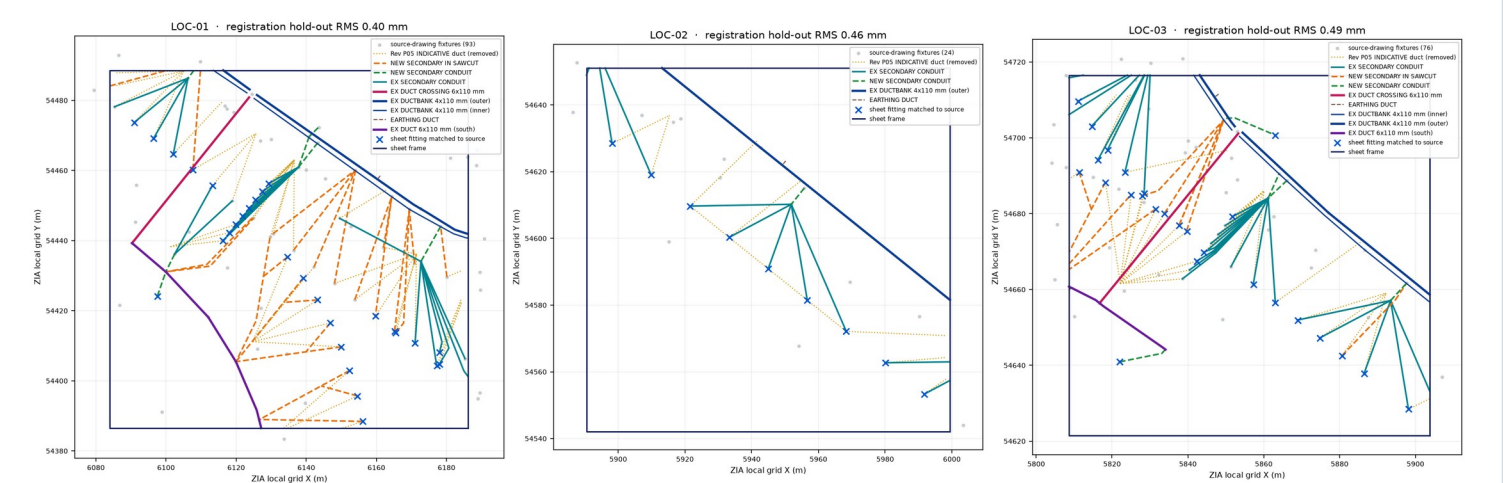

SHEET 7 — SECONDARY FEED TOPOLOGY (DERIVED) · STAR FROM TRANSFORMER HANDHOLES, NOT A CHAINED RUN

FINDING — THE Rev P05 LOC-02 SCOPE NOTE DESCRIBES THE WRONG TOPOLOGY

Rev P05, sheet 3 (LOC-02) states: "SECONDARY DUCT: CHAINED RUN HH.E.056 → 03/007 → 04/007 → 03/008 → 04/008 → 03/009 → HH.E.054". The source drawing shows no such chain. Every affected light at LOC-02 is fed by its own individual conduit spur radiating from ONE transformer handhole — five separate home runs of 20.5, 21.1, 29.1, 30.3 and 41.5 m, 142.5 m in total, not a series loop between lights. This changes the cable quantity, the number of pulls and the isolation sequence. Re-price and re-plan LOC-02 before ordering cable.

WHY THIS ALSO PROVES THE GEOMETRY IS REAL

The conduit fragments were chained by snapping endpoints within 0.30 m. What comes out is not an arbitrary set of lines — it is a working secondary distribution network:

- Every hub node lands on a CV_ETRANS HH (existing transformer handhole) fixture at 0.000-0.002 m. Four hubs at LOC-01, one at LOC-02, two at LOC-03.
- 40 of 45 spurs terminating at a light land within 50 mm of that light's insertion point; most are exactly 0.00 m.
- Spur lengths are 6–42 m, consistent with transformer-handhole-to-light home runs.

Straight light-to-nearest-pit construction lines cannot produce that. Invented or inferred geometry would not terminate on fixture insertion points to the millimetre, nor converge specifically on transformer handholes rather than on any nearby pit.

METHOD AND ITS LIMIT

The source drawing stores these conduits as loose LINE / LWPOLYLINE segments with no connectivity. The chaining here is DERIVED, not read from the drawing: endpoints within 0.30 m were treated as one node, then each branch was walked outward from its hub until it reached a leaf or a junction. Consequence: a spur length is the drawn geometry of a branch, not a proven pull. Two conduits passing within 0.30 m without physically joining would be merged; a genuine joint drawn with a wider gap would be split. Prove each run on site before ordering. The 0.30 m tolerance sits far below the shortest real spur (6.2 m) and well above the drafting gaps observed. No spur changed hop count when the tolerance was varied between 0.10 and 0.50 m.

LOC-01 — DERIVED SPUR SCHEDULE			
4 transformer-handhole hub(s) · 26 spurs · 516.9 m to lights			
Length	Terminates at	Source layer	Offset
35.44 m	Taxiway centreline light	EL-TAXICL	5.13 m !
31.36 m	Taxiway centreline light	EL-TAXICL	0.00 m
30.40 m	Taxiway centreline light	EL-TAXICL	0.00 m
30.08 m	Taxiway centreline light	EL-TAXICL	0.06 m !
30.08 m	Stop bar light	EL-STOPBAR	0.04 m
27.17 m	Stop bar light	EL-STOPBAR	0.00 m
26.84 m	Taxiway centreline light	EL-TAXICL	0.00 m
26.21 m	Taxiway edge light	EL-TAXIWAY EDGE	0.07 m !
26.02 m	Taxiway edge light	EL-TAXIWAY EDGE	0.00 m
24.20 m	Stop bar light	EL-STOPBAR	0.00 m
23.28 m	Taxiway centreline light	EL-TAXICL	0.00 m
22.49 m	Taxiway centreline light	EL-TAXICL	0.03 m
22.42 m	Taxiway centreline light	EL-TAXICL	0.00 m
22.33 m	Taxiway centreline light	EL-TAXICL	0.00 m
21.99 m	Taxiway centreline light	EL-TAXICL	0.00 m
21.24 m	Stop bar light	EL-STOPBAR	0.00 m
19.86 m	Taxiway centreline light	EL-TAXICL	0.00 m
19.69 m	Taxiway centreline light	EL-TAXICL	0.00 m
18.29 m	Stop bar light	EL-STOPBAR	0.00 m
15.37 m	Stop bar light	EL-STOPBAR	0.00 m
12.96 m	Sign foundation	EL-SGN-FNDTN	0.00 m
12.84 m	Sign foundation	EL-SGN-FNDTN	0.28 m !
12.48 m	Stop bar light	EL-STOPBAR	0.00 m
9.66 m	Stop bar light	EL-STOPBAR	0.00 m
8.85 m	Handhole	CV_HH	0.00 m
2.83 m	Existing transformer handhole	CV_ETRANS HH	2.83 m !
! offset >50 mm — confirm the termination on site			

LOC-02 — DERIVED SPUR SCHEDULE			
1 transformer-handhole hub(s) · 6 spurs · 142.5 m to lights			
Length	Terminates at	Source layer	Offset
41.50 m	Taxiway centreline light	EL-TAXICL	0.00 m
30.30 m	Taxiway centreline light	EL-TAXICL	0.00 m
29.10 m	Taxiway centreline light	EL-TAXICL	0.00 m
21.10 m	Taxiway centreline light	EL-TAXICL	0.00 m
20.52 m	Taxiway centreline light	EL-TAXICL	0.00 m
6.23 m	Handhole	CV_HH	0.00 m
! offset >50 mm — confirm the termination on site			

LOC-03 — DERIVED SPUR SCHEDULE			
2 transformer-handhole hub(s) · 20 spurs · 412.1 m to lights			
Length	Terminates at	Source layer	Offset
31.97 m	Taxiway centreline light	EL-TAXICL	0.00 m
31.13 m	Stop bar light	EL-STOPBAR	0.00 m
29.02 m	Taxiway centreline light	EL-TAXICL	0.00 m
28.16 m	Stop bar light	EL-STOPBAR	0.00 m
27.57 m	Taxiway centreline light	EL-TAXICL	0.00 m
25.99 m	Runway guard light / RRM	EL-RRM	4.99 m !
25.23 m	Stop bar light	EL-STOPBAR	0.00 m
25.07 m	Taxiway centreline light	EL-TAXICL	0.00 m
23.13 m	Taxiway centreline light	EL-TAXICL	0.00 m
22.34 m	Stop bar light	EL-STOPBAR	0.00 m
21.12 m	Taxiway centreline light	EL-TAXICL	0.00 m
20.68 m	Taxiway centreline light	EL-TAXICL	0.07 m !
20.57 m	Taxiway centreline light	EL-TAXICL	0.00 m
20.47 m	Taxiway centreline light	EL-TAXICL	0.00 m
19.24 m	Stop bar light	EL-STOPBAR	0.00 m
16.34 m	Stop bar light	EL-STOPBAR	0.00 m
13.46 m	Stop bar light	EL-STOPBAR	0.00 m
10.65 m	Stop bar light	EL-STOPBAR	0.00 m
7.00 m	Handhole	CV_HH	0.00 m
6.80 m	Handhole	CV_HH	0.00 m
! offset >50 mm — confirm the termination on site			

SHEET 8 — AS-BUILT AGL ASSET SYMBOL SCHEDULE · TWY E (E4-E6) REV P06

HOW TO READ THIS

Circle = light · square = civil chamber · triangle = earthing · filled rectangle = sign foundation. Lights are coloured to the light's own showing: taxiway centreline green, taxiway edge blue, stop bar red, runway guard amber. A dashed outline marks the source drawing's "existing" layer for that family. Asset type is taken from the source-drawing LAYER, never from the label on the sheet. Assets that carry a Rev P05 works-action marker keep that marker instead of a type symbol — their type is in the ID label and in this schedule. Counts are assets inside each sheet frame.

SYMBOL · ASSET TYPE · SOURCE LAYER · COUNT PER SHEET

Symbol	Asset type	Source drawing layer(s)	LOC-01	LOC-02	LOC-03	Total in frame
	TWY CENTRELINE LIGHT	EL-TAXICL	31	9	23	63
	TWY EDGE LIGHT	EL-TAXIWAY EDGE	4	—	—	4
	STOP BAR LIGHT	EL-STOPBAR	8	—	8	16
	RUNWAY GUARD LIGHT / RRM	EL-RRM	6	5	9	20
	EXISTING LIGHT BASE (NO FITTING)	EL-EBASE	—	—	4	4
	SIGN FOUNDATION	EL-SGN-FNDTN	2	—	2	4
	HANDHOLE (HH)	CV_HH	11	2	7	20
	TRANSFORMER HANDHOLE (SECONDARY FEED HUB)	CV_ETRANS HH	5	1	2	8
	MANHOLE (MH)	CV_MH	2	—	2	4
	TRANSFORMER MANHOLE (SEC. FEED)	CV_ETRANS MH	2	—	2	4
	EARTHING POINT	CV_GRND	10	3	7	20
	EARTHING PIT	CV_GRND PIT	1	1	—	2
TOTAL — 12 asset types			82	21	66	169

Of these, Rev P05 drew no symbol at all for 42 assets on LOC-01, 12 on LOC-02 and 31 on LOC-03 — they are added in Rev P06 from the as-built and are NOT field-verified. asset_census.json accompanies this deck.